



SCALE: 1" = 20'

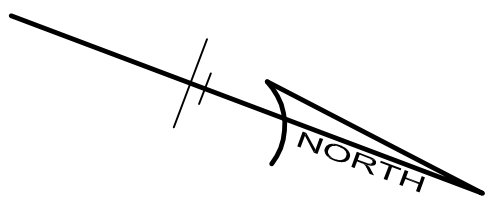

PINE STREET 66.0' R/W ~ PINE STREET COMPLETED ~ (** EXCEPT PAINT STRIPING)

NOTES:
 March 28, 2018 - Construction of Sanitary and Storm Sewer Lines, Water Lines, and 24.0' Drive - North Parking Garage Pad Complete
 April 5, 2018 - North Parking Garage Pad Complete
 May 20, 2018 - Opened 5th Street to Traffic, 4th Parking Garage (Rear)

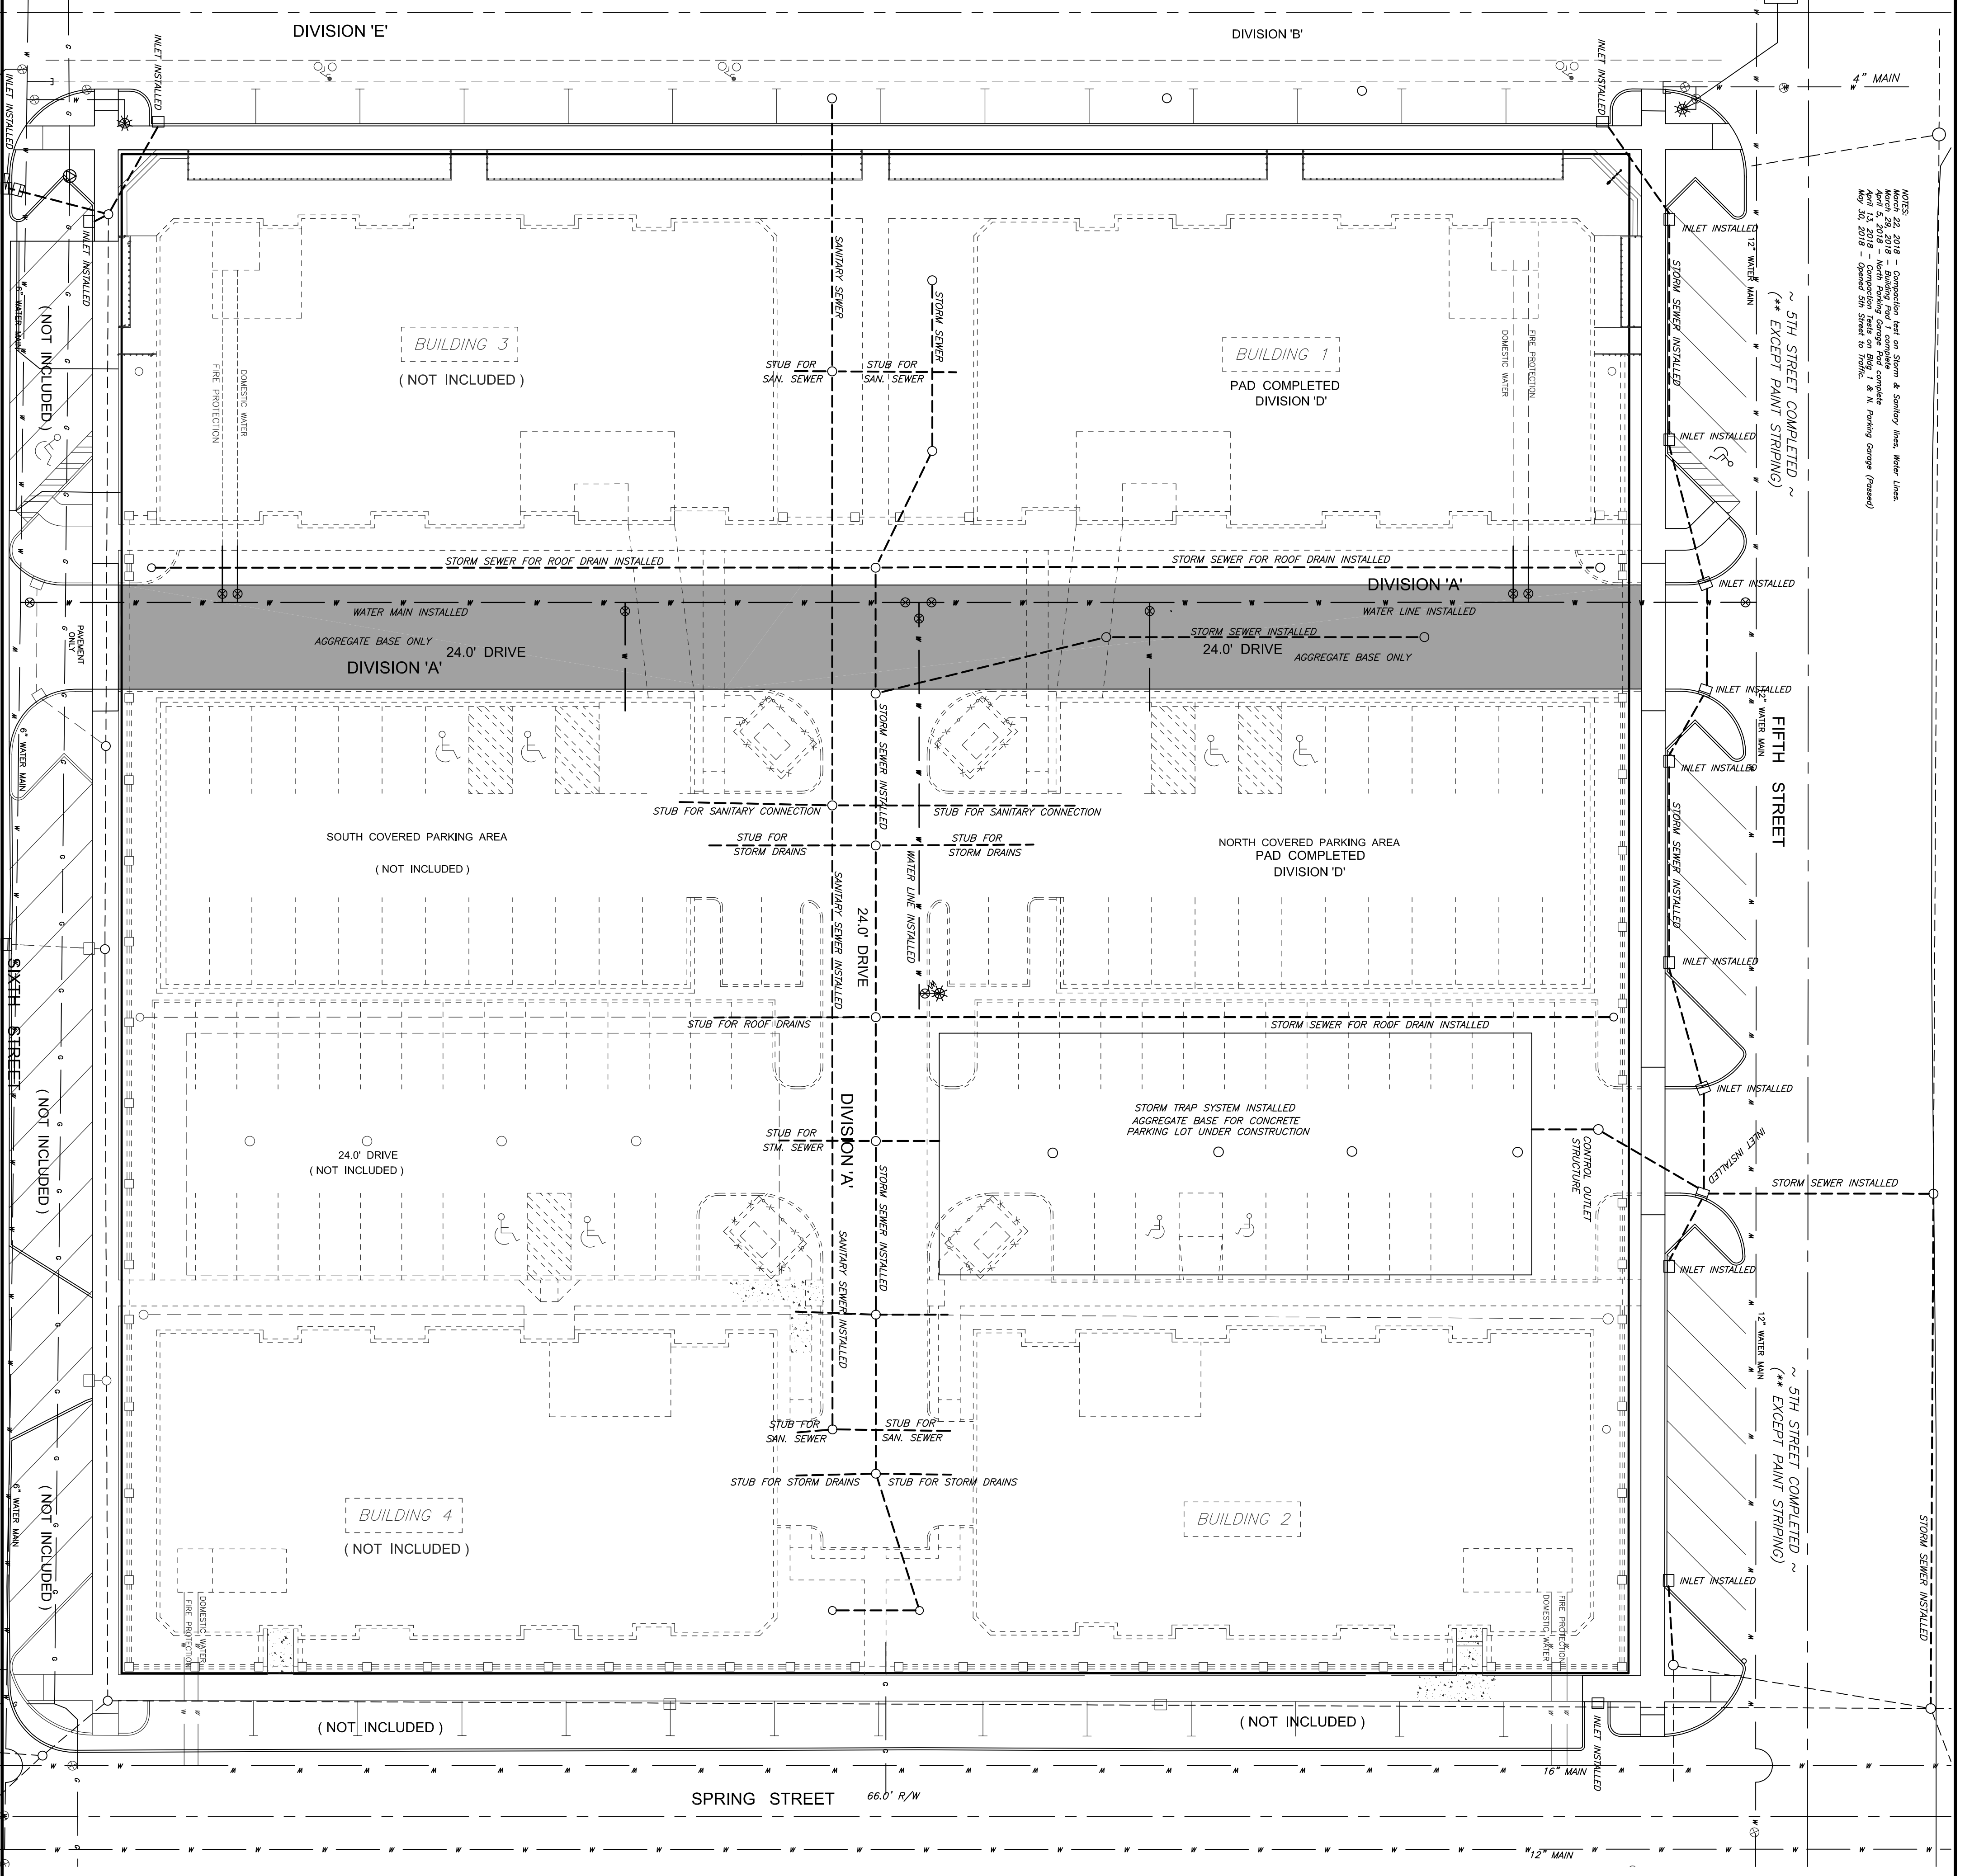


DIVISION 'A'
 INTERIOR INFRASTRUCTURE CONSTRUCTION
 DIVISION 'B'
 EXTERIOR INFRASTRUCTURE CONSTRUCTION
 EXTERIOR ROAD CONSTRUCTION
 DIVISION 'C'
 REMOVAL OF EXISTING INTERIOR UTILITIES
 DIVISION 'D'
 CONSTRUCTION OF BUILDING #1 PAD
 CONSTRUCTION OF NORTH PARKING GARAGE PAD
 DIVISION 'E'
 PINE ST. EXPANSION - MID BLOCK SOUTH TO 6TH ST.
 INCLUDING NE CORNER OF 6TH ST. & PINE ST.

CURRENT AS BUILTS:
 OCTOBER 04, 2018

ELSTON'S LEGACY APARTMENTS

THE REPLAT OF FRACTIONAL BLOCK 21 IN ELSTON'S ORIGINAL SURVEY and FRACTIONAL BLOCK 4 DUNCAN'S ADDITION ALL IN MICHIGAN CITY, LAPORTE COUNTY, INDIANA

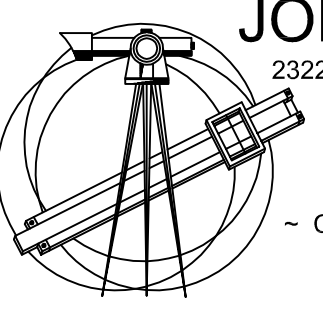

JOHN A. DOYLE & ASSOCIATES INCORPORATED
 2322 E. MICHIGAN BLVD., MICHIGAN CITY, INDIANA
 PHONE: (219) 872-2221 FAX: (219) 879-3857
 EMAIL: JOHNADOYLE@COMCAST.NET
 - CIVIL ENGINEERS AND LAND SURVEYORS -
 REGISTERED IN INDIANA & MICHIGAN

REVISIONS:
 1. DATE: 10/04/18 BY: [Signature] DESCRIPTION: [Text]
 2. DATE: 10/04/18 BY: [Signature] DESCRIPTION: [Text]
 3. DATE: 10/04/18 BY: [Signature] DESCRIPTION: [Text]

DATE: OCTOBER 04, 2018
 FILE NO. ELA-ASBUILTS-2018.DWG